INFORMATION HANDOUT

For Contract No. 07-4T5704
At 07-LA-105-R0.5

Identified by
Project ID 0712000121

MATERIALS INFORMATION

ITS As BUILT

DIST	COUNTY	ROUTE	POST MILES TOTAL PROJECT	SHEET NO.	TOTAL SHEETS
07	LA	105	R0.5/17.8	21	92

Kenneth D. Camp 3/23/93
REGISTERED ELECTRICAL ENGINEER

4-26-93
PLANS APPROVAL DATE

REGISTERED PROFESSIONAL ENGINEER KENNETH D CAMP No. E012917 Exp. 3/31/93 ELECTRICAL STATE OF CALIFORNIA

DKS ASSOCIATES
1055 WEST SEVENTH ST., SUITE 2850
LOS ANGELES, CA 90017

IN ASSOCIATION WITH:

KDC ARCHITECTS - ENGINEERS
1055 WEST SEVENTH ST., SUITE 2890
LOS ANGELES, CA 90017

CONDUCTOR SCHEDULE			
CONDUCTOR TYPE	FUNCTION	RUN 2	RUN 10
6 P22 CABLE	CONTROLLER DATA	1	1
2 MMFO	SHORT HAUL VIDEO		1
	CONDUIT SIZE	2"	2"

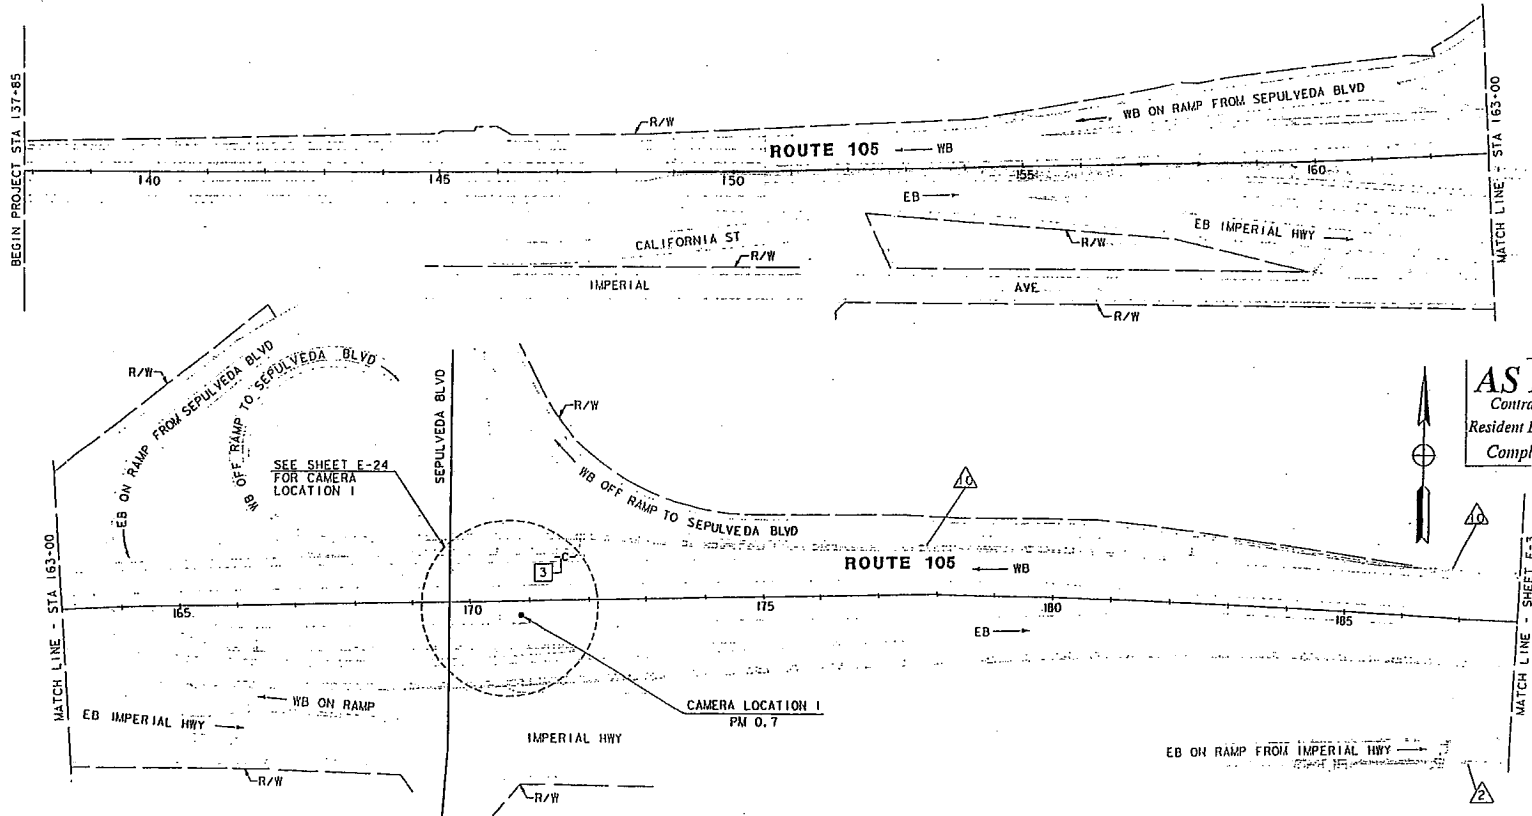

AS BUILT 119904
Contract No. 07-
Resident Engineer: Hillel Amos
Completion Date: October 3, 1997

CCTV AND COMMUNICATIONS SYSTEM ROUTING

SCALE: 1" = 100'

NOTE: THIS PLAN ACCURATE FOR ELECTRICAL ONLY.
SEE SHEET E-1 FOR LEGEND AND PROJECT NOTES.

E-2

CALCULATED/DESIGNED BY	DATE	REVISED BY
RL	3/93	
CHECKED BY	DATE REVISED	
RS	3/93	

DESIGN OVERSIGHT: GLORIA GWYNNE

STATE OF CALIFORNIA - DEPARTMENT OF TRANSPORTATION

Caltrans

FORM DC-DE-92-PF (REV. 3/88)

FOR REDUCED PLANS ORIGINAL SCALE IS IN INCHES 0 1 2 3

CU 07374 | EA 119900

LAST REVISION 03-23-93

/usr/richard/P57/T119900.02. 06-MAY-1993 12:53 richard